
RT No. TGM-04-210R-xx

1 REV.

Rt=12 (G Rt=0.8 Lap Rt=0.8)

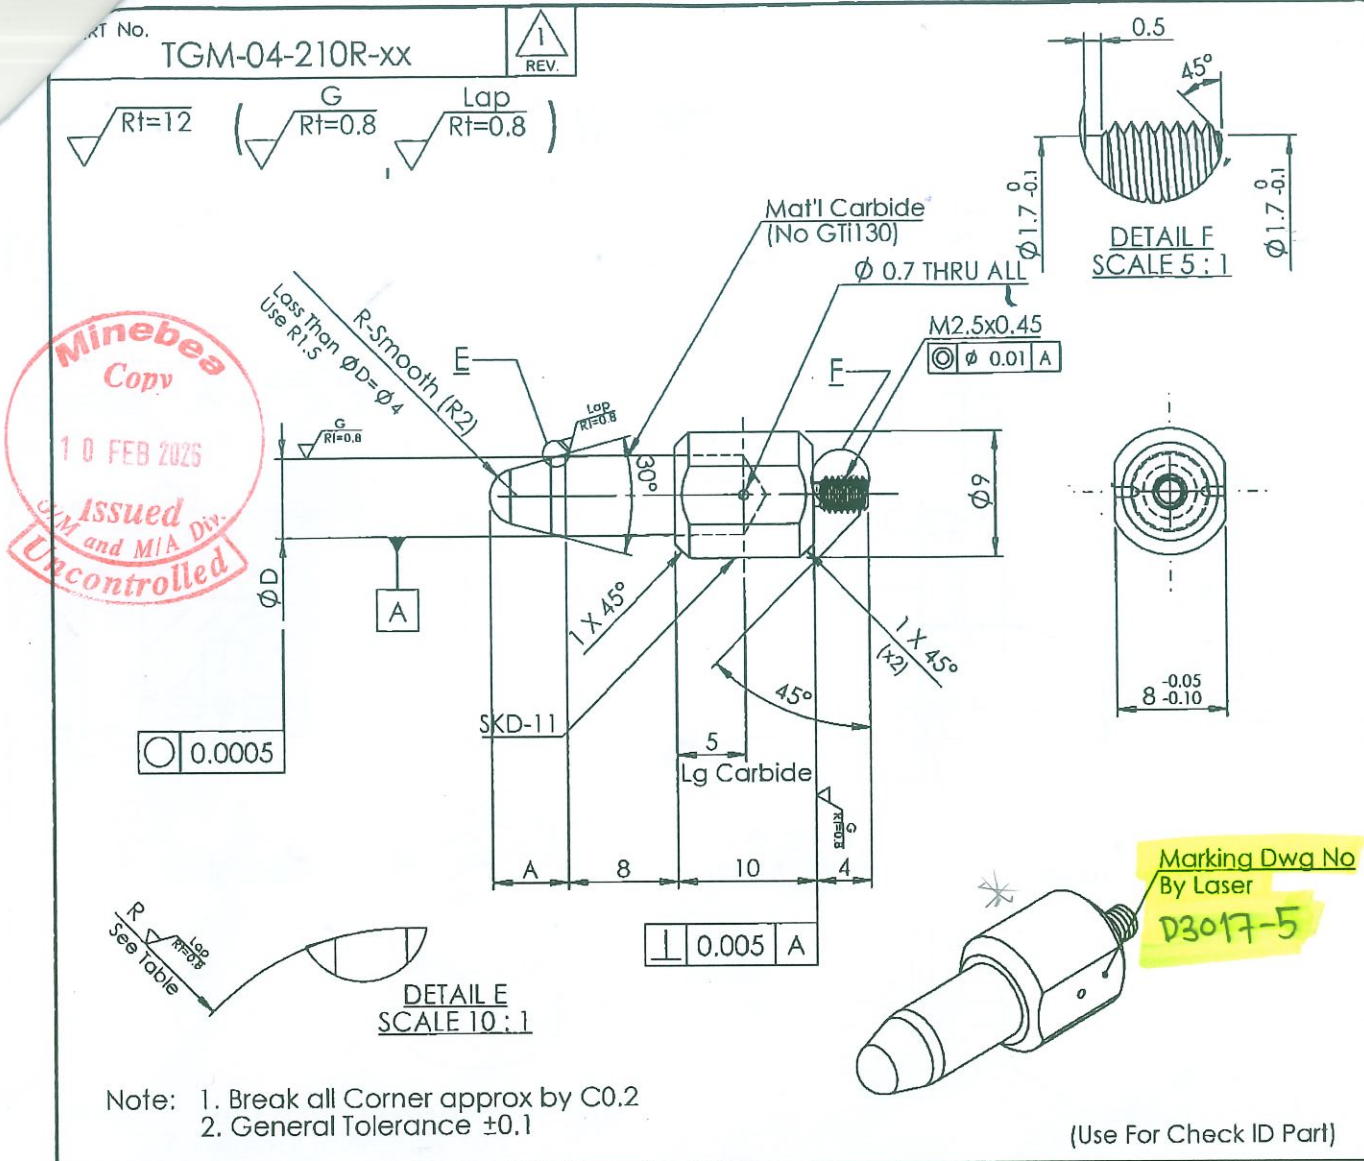

Minebea Copy
10 FEB 2025
Issued GM and M/A Div.
Uncontrolled

Marking Dwg No
By Laser
D3017-5

Note: 1. Break all Corner approx by C0.2
2. General Tolerance ±0.1

(Use For Check ID Part)

ITEM	ØD	R	A	For Spec	For Part No	Check
-01	Ø6.337 0 -0.001	4	6.6	Ø6.335 +0.002 -0.008	~~F3005-5~~ FD3017-5 ~~J3001-5~~ ~~A4368-5~~ ~~FF30055-DEP1~~	Rq : 28/21
-02	Ø3.987 0 -0.0005	2	6.4	Ø3.987 0 -0.008	F2008-5	
-03	Ø4.985 0 -0.0005	2	6.4	Ø4.985 0 -0.01	D4007-5 F2010-5 FF2016-5-12	
-04	Ø4.988 0 -0.0005	2	6.4	Ø4.986 +0.002 -0.008	D4002-5 D4004-5	
-05	Ø3.99 0 -0.0005	2	6.4	Ø3.988 +0.002 -0.008	J4003-5	
-06	Ø4.986 0 -0.0005	2	6.4	Ø4.986 0 -0.01	D4011-5	
-07	Ø6.335 0 -0.0005	4	6.6	Ø6.335 0 -0.008	A43685 Turning	
-08	Ø6.335 0 -0.0005	4	6.6	Ø6.335 0 -0.01	A43685 Complete FF3020-5 RQ290/19 E30095-AAP1 RQ59/20 E3009-5 RQ251/20	406/18 (Puwanai)
-09	Ø4.985 0 -0.0005	0.1	6.4	Ø4.985 0 -0.01	FF2016-5-12	
-10	Ø6.362 0 -0.0005	4	6.6	Ø6.357 ±0.005	FD3021-5-01	Rq : 331/18
-11	Ø6.45 0 -0.0005	4	6.6	Ø6.44 ±0.005	FD5A01-5	Rq : 519/20
-12	Ø5.7 0 -0.0005	4	5.4	Ø5.65 ±0.05	FJ4003-4	Rq : 40/21
-13	Ø5.42 0 -0.0005	4	4.9	Ø5.4 ±0.02	FD4007-4	Rq : 40/21
-14						
-15						

REV.	ECN No.	DATE	NAME	DESCRIPTION
1	---	---	---	ENGINEERING RELEASE

UNLESS SPECIFIED C0.1 OR R0.1	
GENERAL TOLERANCE	
JISB0405 MACHINING WORKING	
LESS THAN 0.5	±0.05
0.5 ~ 6	±0.1
6 ~ 30	±0.2
30 ~ 120	±0.3
120 ~ 400	±0.4
400 ~ 1000	±0.8
ANGLE	±1°

0.8S 6.3S 25S 100S - UNCUT

M/C.	Q'ty
MV.4	1

MATERIAL No. GTi30 Carbide, SKD-11

FINISH -

HEAT TREATMENT -

List Request No. 627/17

3 RD ANGLE

SCALE : SHEET / UNIT (mm.)

DETAILED	DESIGNED	CHECKED	APPROVED
Chalrach			

DATE 20 Dec' 17

MinebeaMitsumi Inc.
General Machining Parts Div. 1

TITLE: Pluge Gauge No Go (R)

PART No. TGM-04-210R-xx

1 REV.