PART No. TGM-31-627D-xx
REV. 1

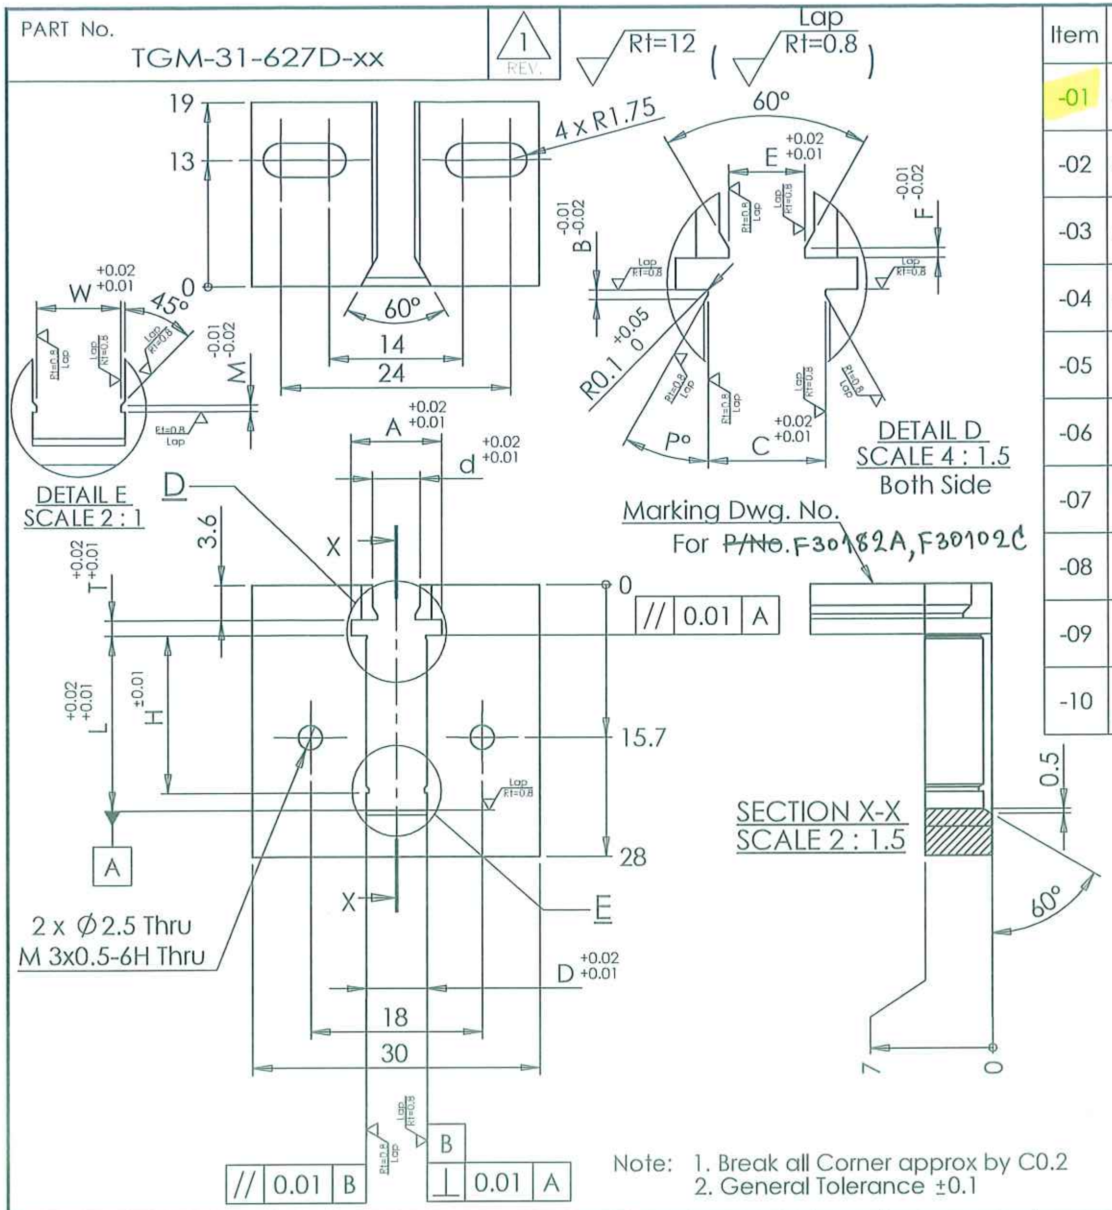

Rt=12
Lap Rt=0.8
19
13
0
4 x R1.75
60°
14
24
W +0.02 +0.01
45°
M -0.01 -0.02
Rt=0.8 Lap
DETAIL E
SCALE 2 : 1
E +0.02 +0.01
F -0.01 -0.02
B -0.01 -0.02
R0.1 +0.05 0
P°
C +0.02 +0.01
DETAIL D
SCALE 4 : 1.5
Both Side
A +0.02 +0.01
d +0.02 +0.01
D
X
3.6
T +0.02 +0.01
// 0.01 A
L +0.02 +0.01
H ±0.01
15.7
28
A
2 x Ø2.5 Thru
M 3x0.5-6H Thru
E
D +0.02 +0.01
18
30
// 0.01 B
B
⊥ 0.01 A
SECTION X-X
SCALE 2 : 1.5
0.5
60°
7
0

Marking Dwg. No.
For ~~P/No.~~ F30182A, F30102C

Note: 1. Break all Corner approx by C0.2
2. General Tolerance ±0.1

Item	D	d	A	T	L	B	C	E	F	H	W	M	P°	For P/No.	Check
-01	6.4	6.2	9.54	3	10.3	0.29	6.18	-	-	9.702	5.92	0.625	30°	F30052FCAP1 F30102ADAP1 F30182AAAP1 F30182A04AAP1 RQ:180/24	PREECHA
-02	6.4	4.5	9.54	1.62	16.6	0.28	6.16	-	-	16.2	5.82	0.44	30°	F30082GAAP1T1 RQ:434/18	PREECHA
-03	6.4	5.9	9.54	1.88	11.48	0.27	6.16	-	-	11.03	5.82	0.67	30°	F30132CAAP1 F30072EAAP2 RQ:434/18	PREECHA
-04	6.4	5.9	9.54	2.03	12.72	0.28	6.17	-	-	12.27	5.81	0.67	30°	F30172-02AAP1 RQ:434/18 F30172-34AAP1 RQ:179/24	PREECHA
-05															
-06															
-07															
-08															
-09															
-10															

Minebea
Copy
15 AUG 2025
Issued
G/M and M/A Div.
Uncontrolled

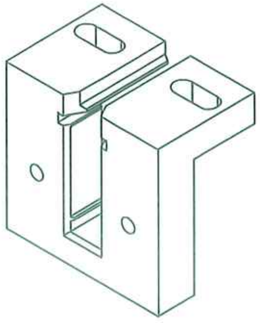

Formula: D = OD. Shaft Part Maximum
d = OD. Small Part Maximum + 0.1
A = OD. Flank Part Maximum + 0.07
T = Lg. OD. Flank Part Maximum + 0.01
L = Lg. Under Flank Part Maximum + 0.01
B = Lg. Under Cut Part T/N. Min
C = OD. Under Cut Part T/N. Maximum + 0.01
E = OD. Under Cut R/L Part Maximum + 0.01
F = Under Cut R/L Part Min -0.05
H = Under Cut Flank - Lg. OD. Guide -0.03
W = OD. Groove Maximum + 0.02
M = Lg. OD. Groove Min

REV.	ECN No.	DATE	NAME	DESCRIPTION
1	----	----	---	ENGINEERING RELEASE

UNLESS SPECIFIED C0.1 OR R0.1
GENERAL TOLERANCE
UNTOLERANCED MACHINING WORKING

LESS THAN 0.5	±0.05
0.5 ~ 6	±0.1
6 ~ 30	±0.2
30 ~ 120	±0.3
120 ~ 400	±0.4
400 ~ 1000	±0.6
ANGLE	±1°

0.8S
6.3S
25S
100S
~ UNCUT

M/C. KCL-50
Q'ty 1
MATERIAL SKD-11
FINISH Buff All Area
HEAT TREATMENT HRC 50-60

List Request No. 399/18
3 RD ANGLE
SCALE :
SHEET /
UNIT (mm.)

DETAILED	DESIGNED	CHECKED	APPROVED
CHONKNOK	CHONKNOK	PREECHA	PREECHA

DATE 16 Jul' 18

NMB MinebeaMitsumi Inc.
General Machining Parts Div. 1

TITLE: Jig Protect Chip (D)

PART No. TGM-31-627D-~~xx~~ 01
REV. 1